


Pen assignments: 1(RED)=0.25; 2(YELLOW)=0.35; 3(GREEN)=0.5; 4(CYAN)=0.7; 5(BLUE)=1.0; 6(MAGENTA)=1.4; 7(WHITE)=0.18; 8/9(GREY)=0.10

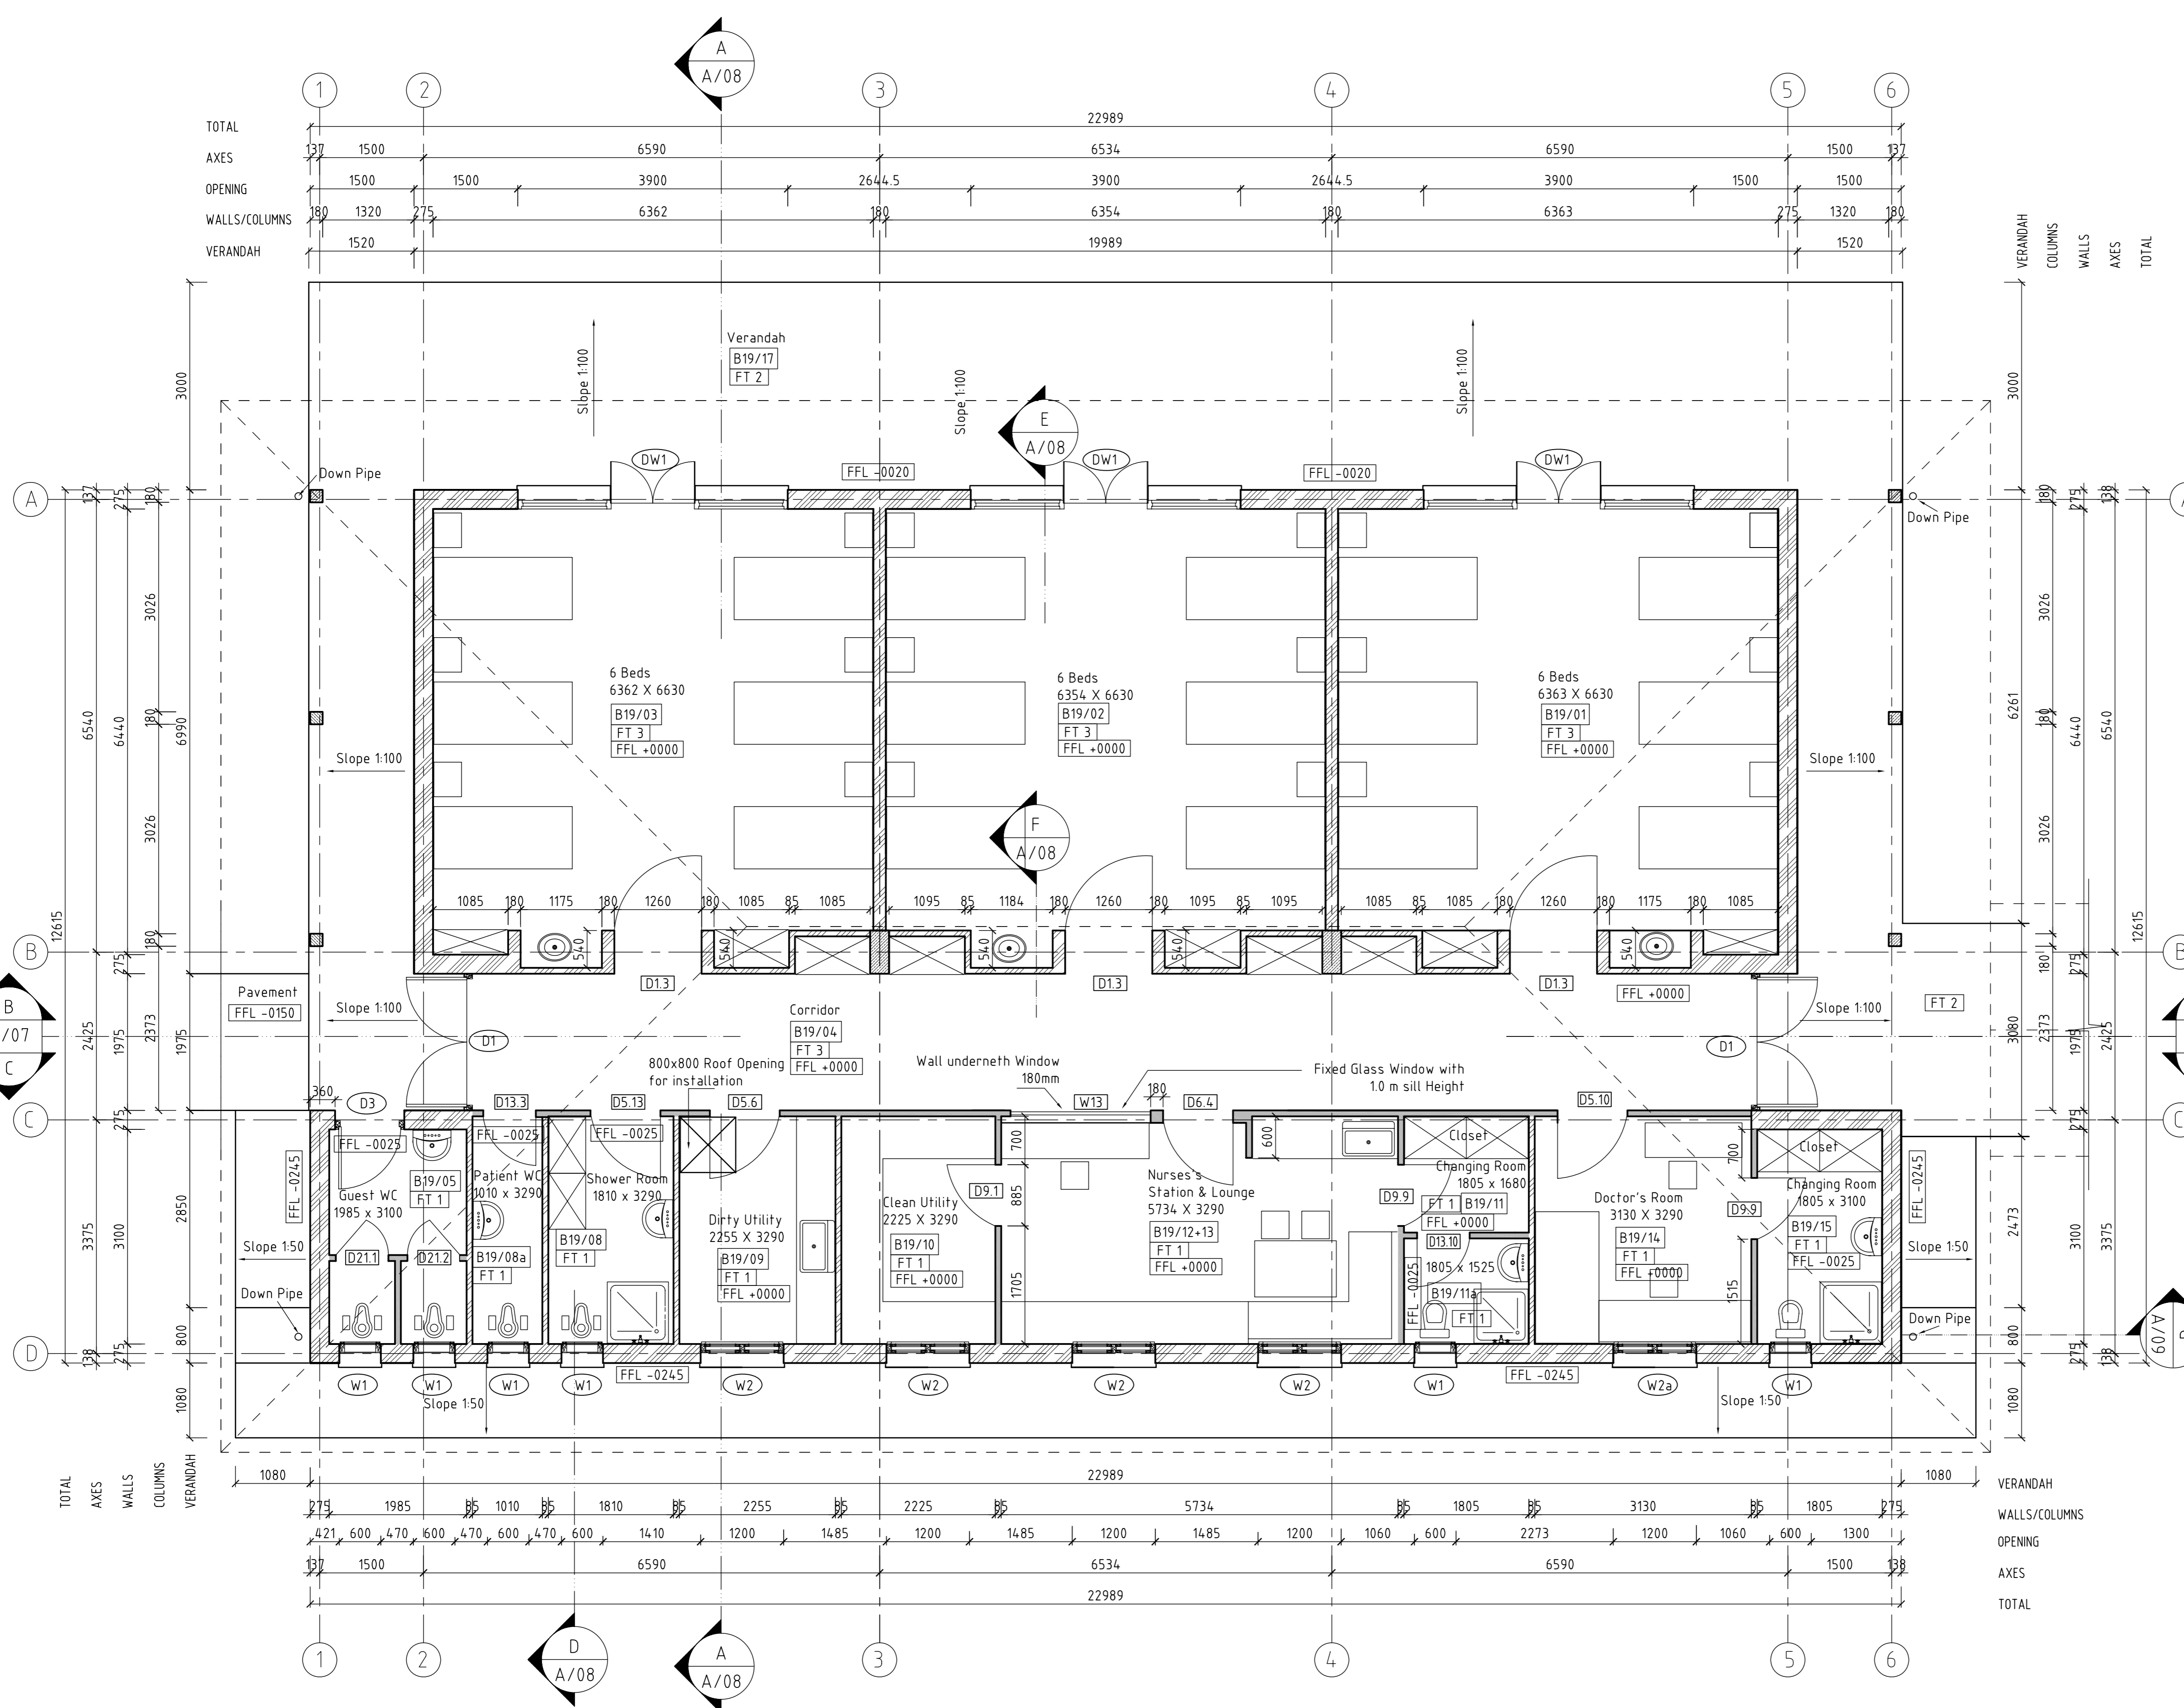

AS-BUILT DRAWING

0 1000 2000 3000 4000 5000mm
SCALE A
±0.000=10.45m ABOVE SEA LEVEL

DOCUMENT No.	DESCRIPTION

REFERENCES

No.	CHECK	APPR	DATE	DESCRIPTION
E				
D				
C				
B				
A				

REVISIONS

No.	CHECK	APPR	DATE	DESCRIPTION

LEGEND

- B27/05 Room Number
- FT 3 Floor Type Epoxy
- FFL +0000 Finished Floor Level
- W5 Window 5
- D1R Door 1 - Right
- DW1L Door Window 1 - Left
- V1 Ventilation 1

- Reinforced Concrete
- Lean Concrete
- Solid Brick Masonry
- Hollow Brick Masonry
- Ventilating Opening

FLOOR PLAN

NOTE:
ALL WALL DIMENSIONS ARE EXCLUSIVE FINISH.

**SONJA KILL
MEMORIAL HOSPITAL FOR CHILDREN
KAMPOT CAMBODIA**

**CONSULTING ENGINEERS
MEKONG LTD**
www.II-consult.com

**JOHN SANDAY
ASSOCIATES**

NAME	DATE
Prep. D.A.K.	
Check R.S.	
Chief Eng.	
P.Mgr.	

**WARD NOT INFECTIOUS
FLOOR PLAN**

PROJECT No.	ORIG. SIZE	ORIG. SCALE	DRAWING No.	REV.
602	A1	1:50	D-B19-AT-01	