
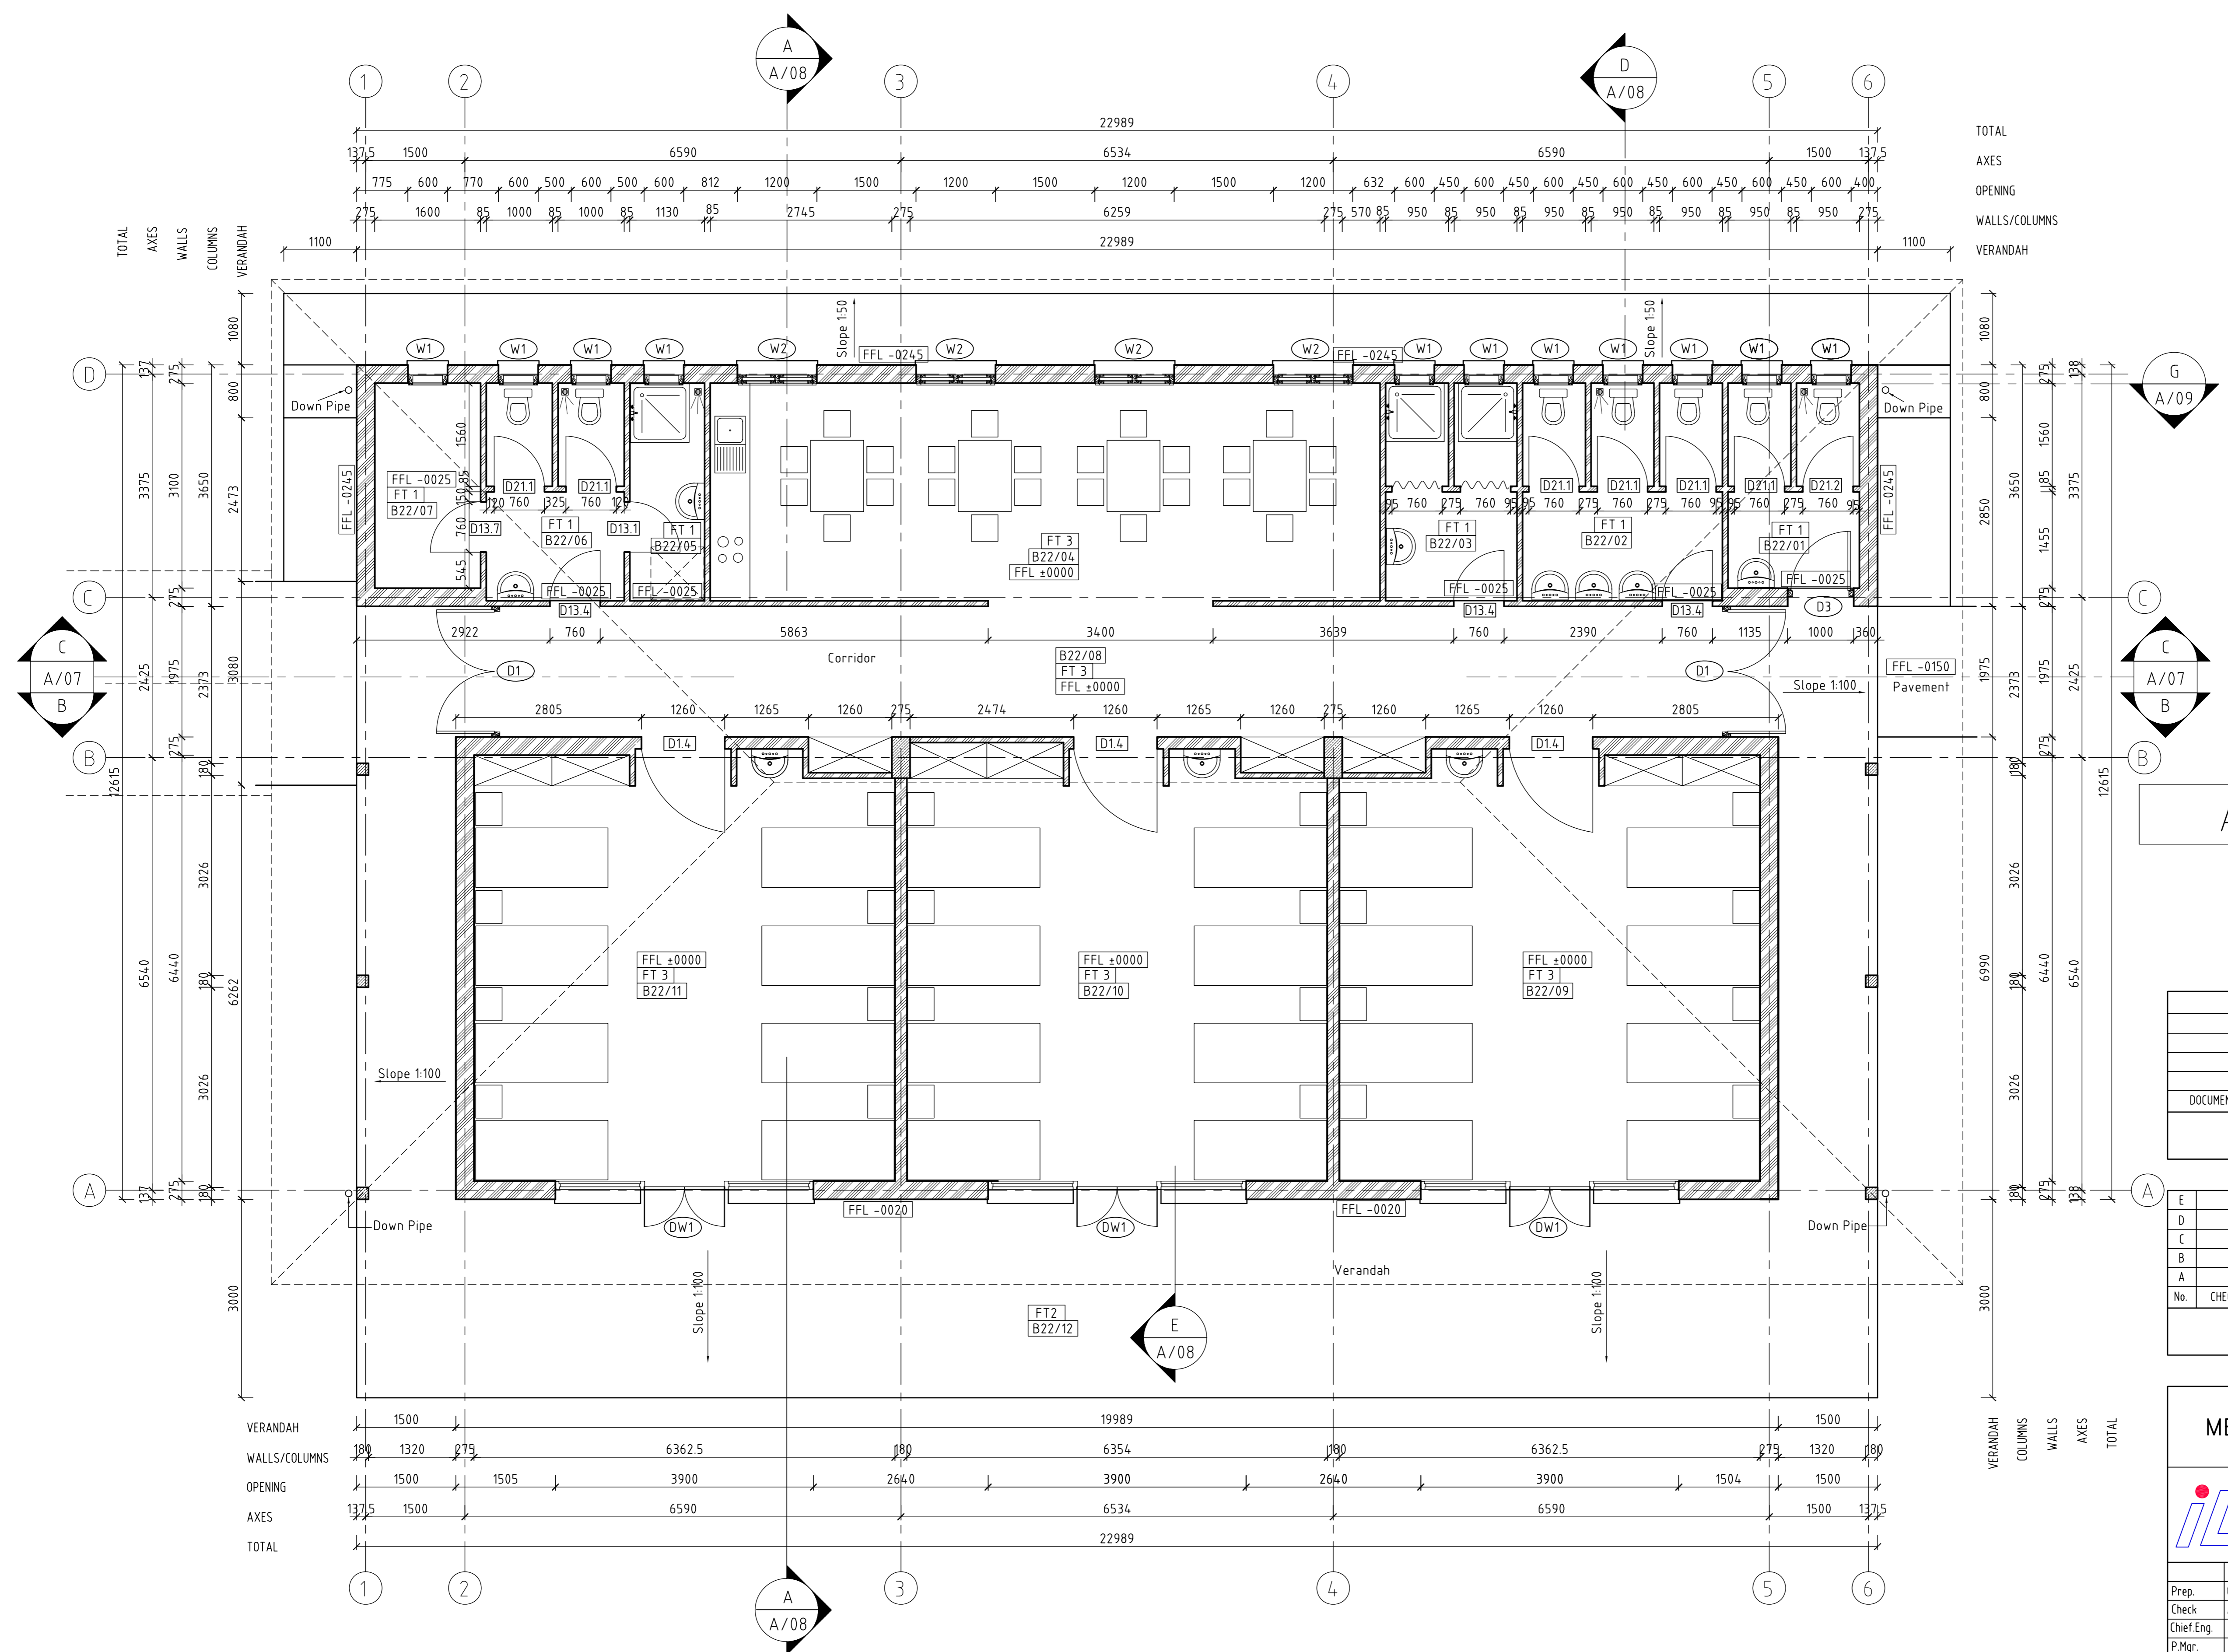


FLOOR PLAN

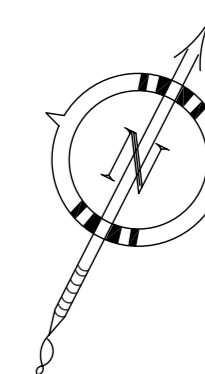


Legend

- Reinforced Concrete
- Lean Concrete
- Solid Brick Masonry
- Hollow Brick Masonry
- Ventilating Opening

- B18/05 Room Number
- FT 3 Floor Type 3 (Epoxy Floor)
- FFL +0000 Finished Floor Level
- W5 Wooden Window (Locally manufactured)
- DW1 Wooden Door (Locally manufactured)
- V1 Wooden Ventilation (Locally manufactured)
- D7 Hoermann Door (Imported)

AS-BUILT DRAWING

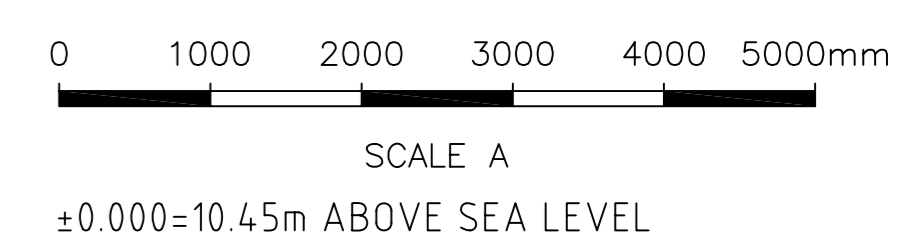

DOCUMENT No.	DESCRIPTION
REFERENCES	

No.	CHECK	APPR	DATE	DESCRIPTION
REVISIONS				

**SONJA KILL
MEMORIAL HOSPITAL FOR CHILDREN
KAMPOT CAMBODIA**

CONSULTING ENGINEERS
MEKONG LTD
www.il-consult.com

JOHN SANDAY
ASSOCIATES

Prep.	NAME	DATE	PARENTS ACCOMMODATION FLOOR PLAN				
Check	ANK	29.09.07					
Chief Eng.							
P.Mgr.							
SUPERSEDED BY DWG. No.			PROJECT No.	ORIG. SIZE	ORIG. SCALE	DRAWING No.	REV.
			602	A1	1:50	D-B22-AT-01	

Pen assignments: 1 (RED)=0.25; 2 (YELLOW)=0.35; 3 (GREEN)=0.5; 4 (CYAN)=0.7; 5 (BLUE)=1.0; 6 (MAGENTA)=1.4; 7 (WHITE)=0.18; 8 (9 (GREY))=0.10