

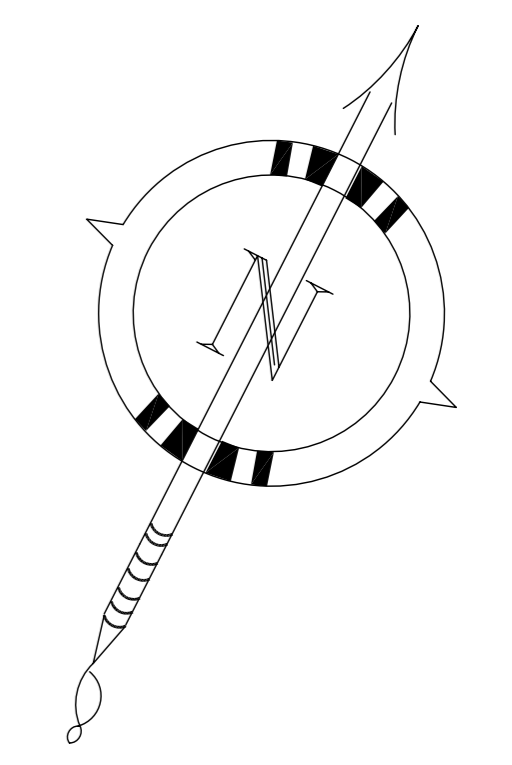


Pen assignments: 1(RED)=0.25; 2(YELLOW)=0.35; 3(GREEN)=0.5; 4(CYAN)=0.7; 5(BLUE)=1.0; 6(MAGENTA)=1.4; 7(WHITE)=0.18; 8/9(GREY)=0.10

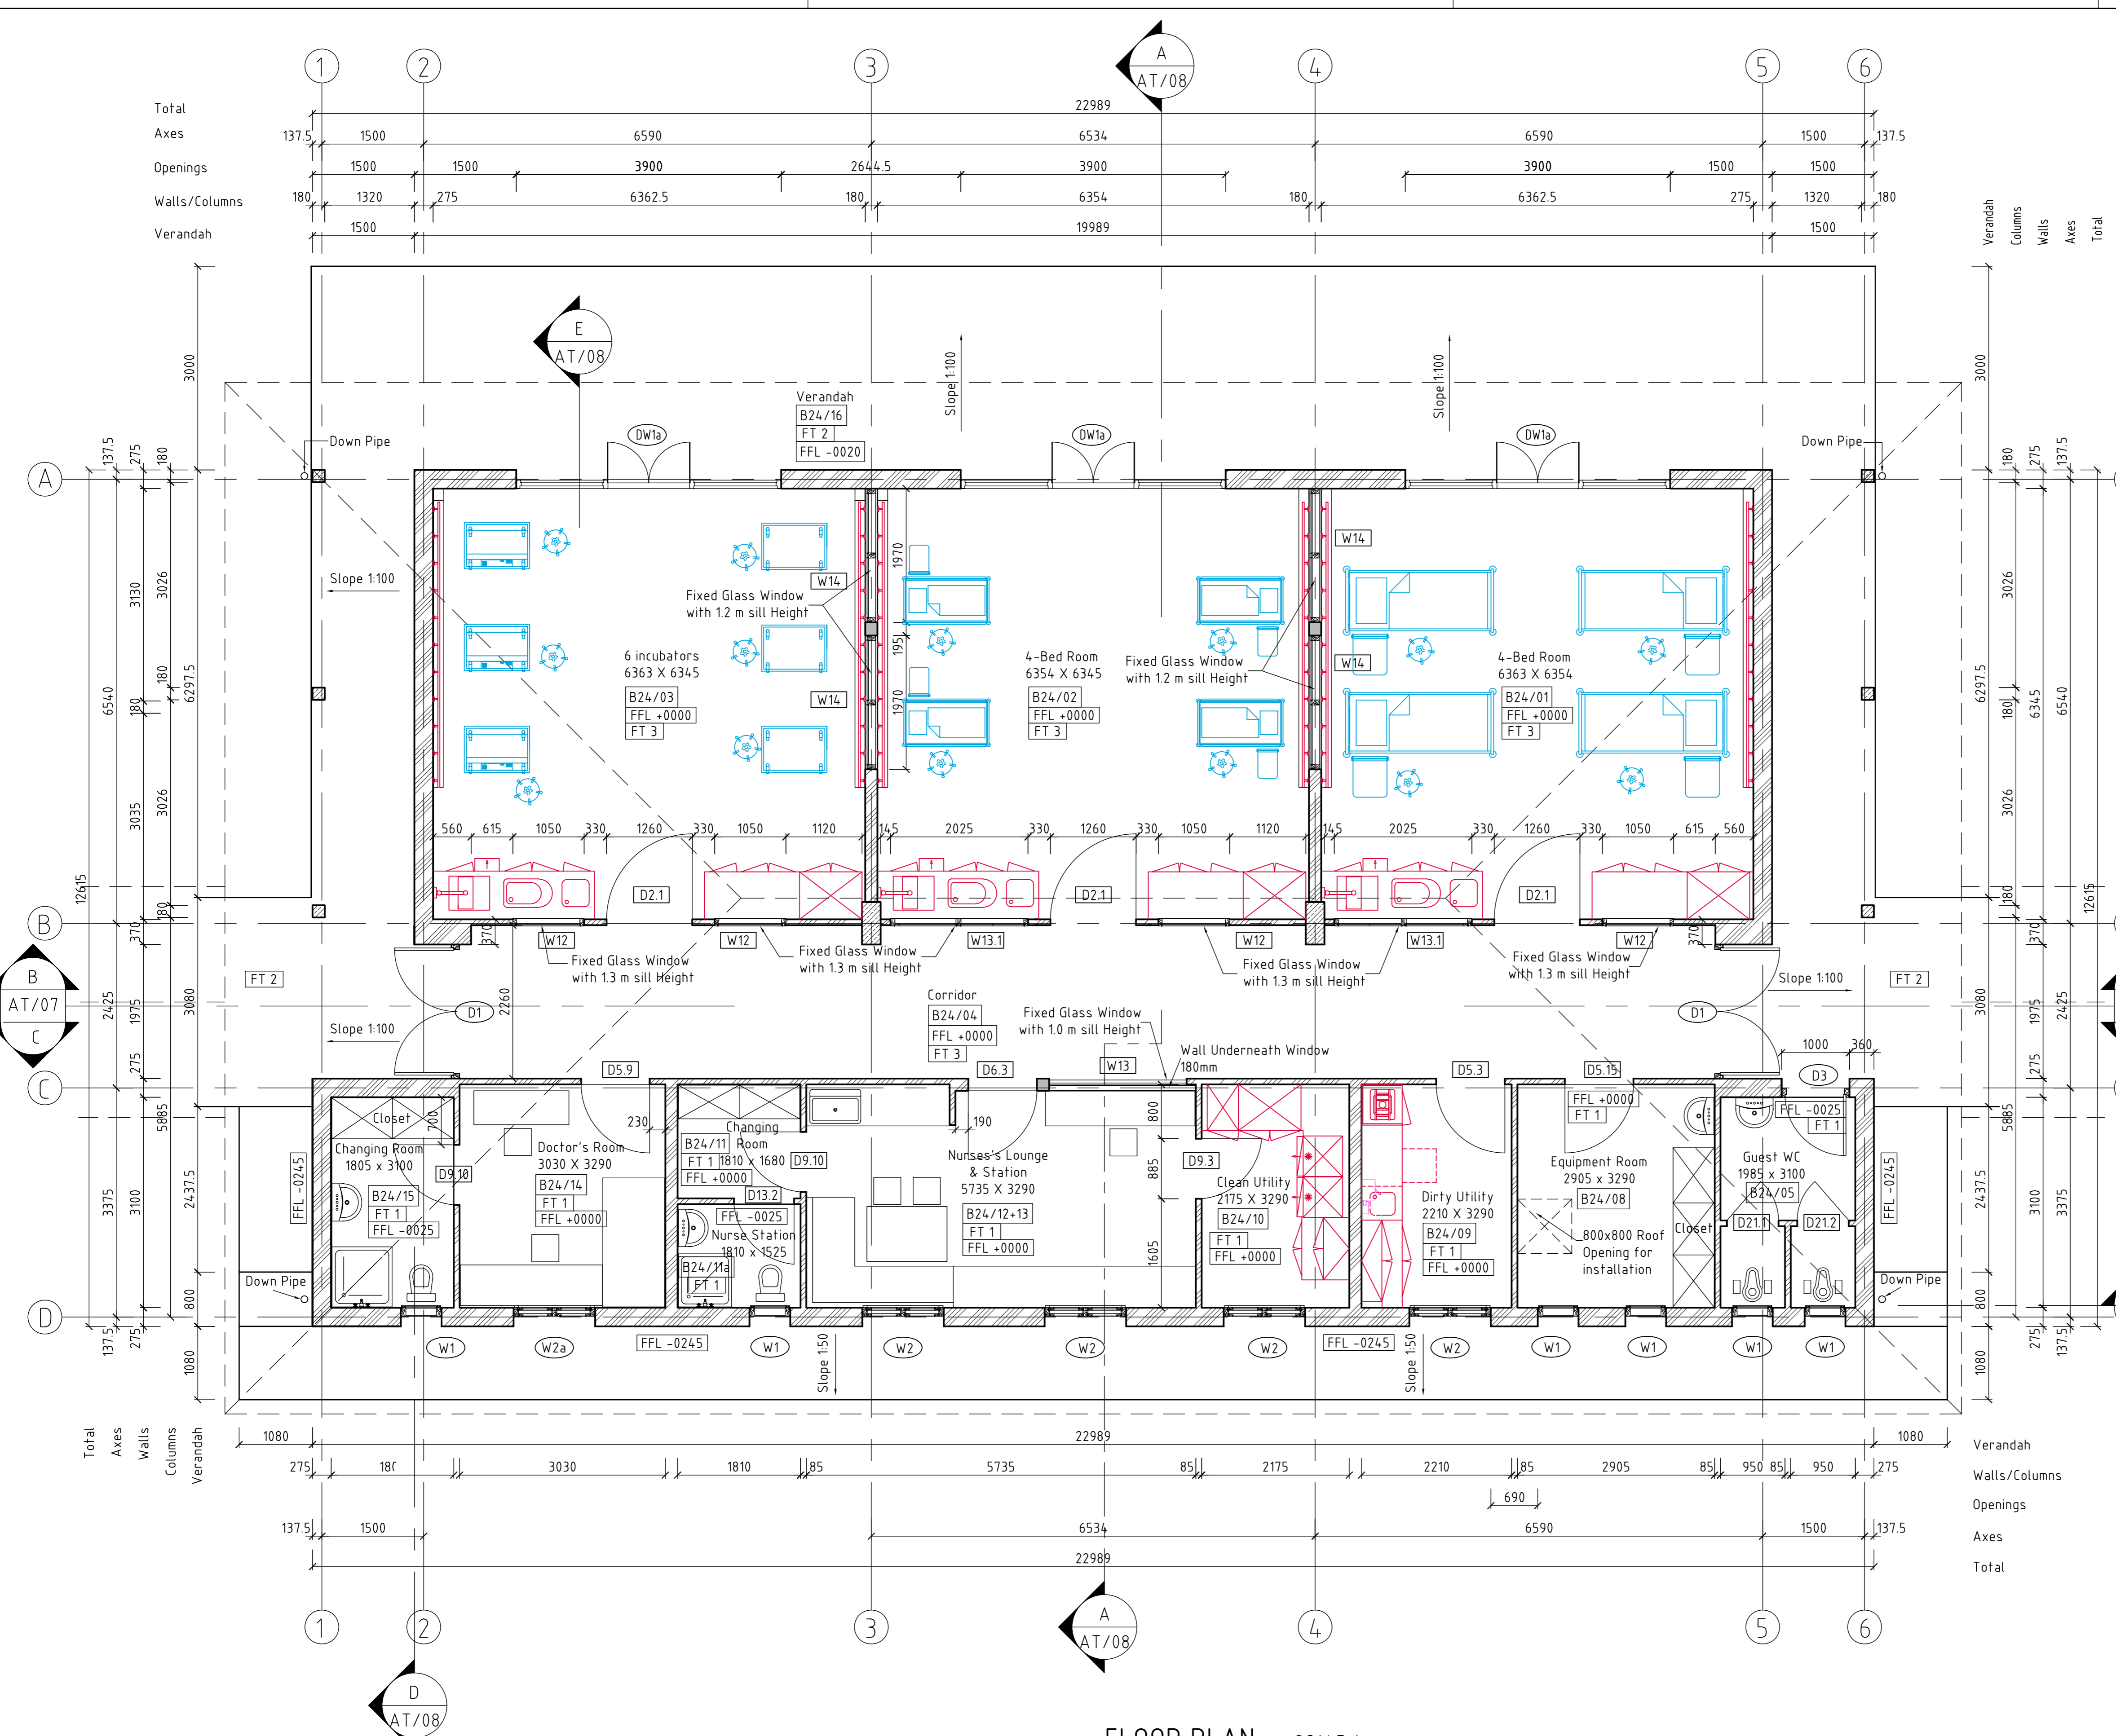

- Legend**
- Reinforced Concrete
 - Lean Concrete
 - Solid Brick Masonry
 - Hollow Brick Masonry
 - Ventilation Opening

AS-BUILT DRAWING

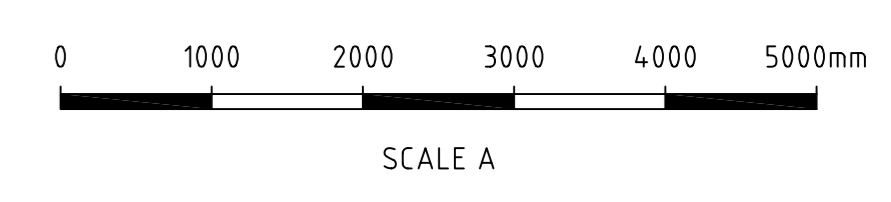

±0.000=10.45m ABOVE SEA LEVEL

NOTE:
ALL WALL DIMENSIONS ARE EXCLUSIVE FINISH.

DOCUMENT No.	DESCRIPTION
REFERENCES	

REVISIONS				
No.	CHECK	APPR	DATE	DESCRIPTION
E				
D				
C				
B				
A				

**SONJA KILL
MEMORIAL HOSPITAL FOR CHILDREN
KAMPOT CAMBODIA**

CONSULTING ENGINEERS
MEKONG LTD
www.ili-consult.com

JOHN SANDAY
ASSOCIATES

NAME	DATE			
Prep. CPR	07.11.07	WARD-INTENSIVE CARE (B24) FLOOR PLAN		
Check ANK	08.11.07			
Chief Eng.				
P.Mgr.				
SUPERSEDED BY DWG. No.				
PROJECT No.	ORIG. SIZE	ORIG. SCALE	DRAWING No.	REV.
602	A1	1:50	D-B24-AT-01	

FLOOR PLAN SCALE A