



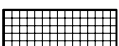

 
 
 


 


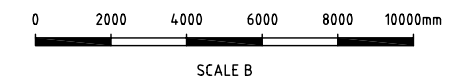
Legend

-  Reinforced Concrete
-  Lean Concrete
-  Solid Brick Masonry
-  Hollow Brick Masonry
-  Ventilation Opening

-  Room Number
-  Floor Type 3 (Epoxy Floor)
-  Finished Floor Level
-  Wooden Window 2 (Locally manufactured)
-  Wooden Door Window 1 (Locally manufactured)
-  Wooden Ventilation 1 (Locally manufactured)
-  Hörmann Doors 7 (Imported)

AS-BUILT DRAWING

±0.000=10.45m ABOVE SEA LEVEL



| DOCUMENT No. | DESCRIPTION |
|-------------------|-------------|
| REFERENCES | |

| No. | CHECK | APPR | DATE | DESCRIPTION |
|------------------|-------|------|------|-------------|
| REVISIONS | | | | |

**SONJA KILL
MEMORIAL HOSPITAL FOR CHILDREN
KAMPOT CAMBODIA**



| | | | | |
|------------------------|-------------------|--------------------------------------------|-------------------------|------|
| NAME | DATE | MATERNITY WARD (B21) FLOOR PLAN | | |
| Prep. C.P.R. | 07.08.07 | | | |
| Check. A.N.K. | 08.08.07 | | | |
| Chief Eng. | | | | |
| P.Mgr. | | | | |
| SUPERSEDED BY DWG. No. | | | | |
| PROJECT No. 602 | ORIG. SIZE A1+190 | ORIG. SCALE 1:100 | DRAWING No. D-B21-AT-01 | REV. |

