



Pen assignments: 1(RED)=0.25; 2(YELLOW)=0.35; 3(GREEN)=0.5; 4(CYAN)=0.7; 5(BLUE)=1.0; 6(MAGENTA)=1.4; 7(WHITE)=0.18; 8(ORANGE)=0.10

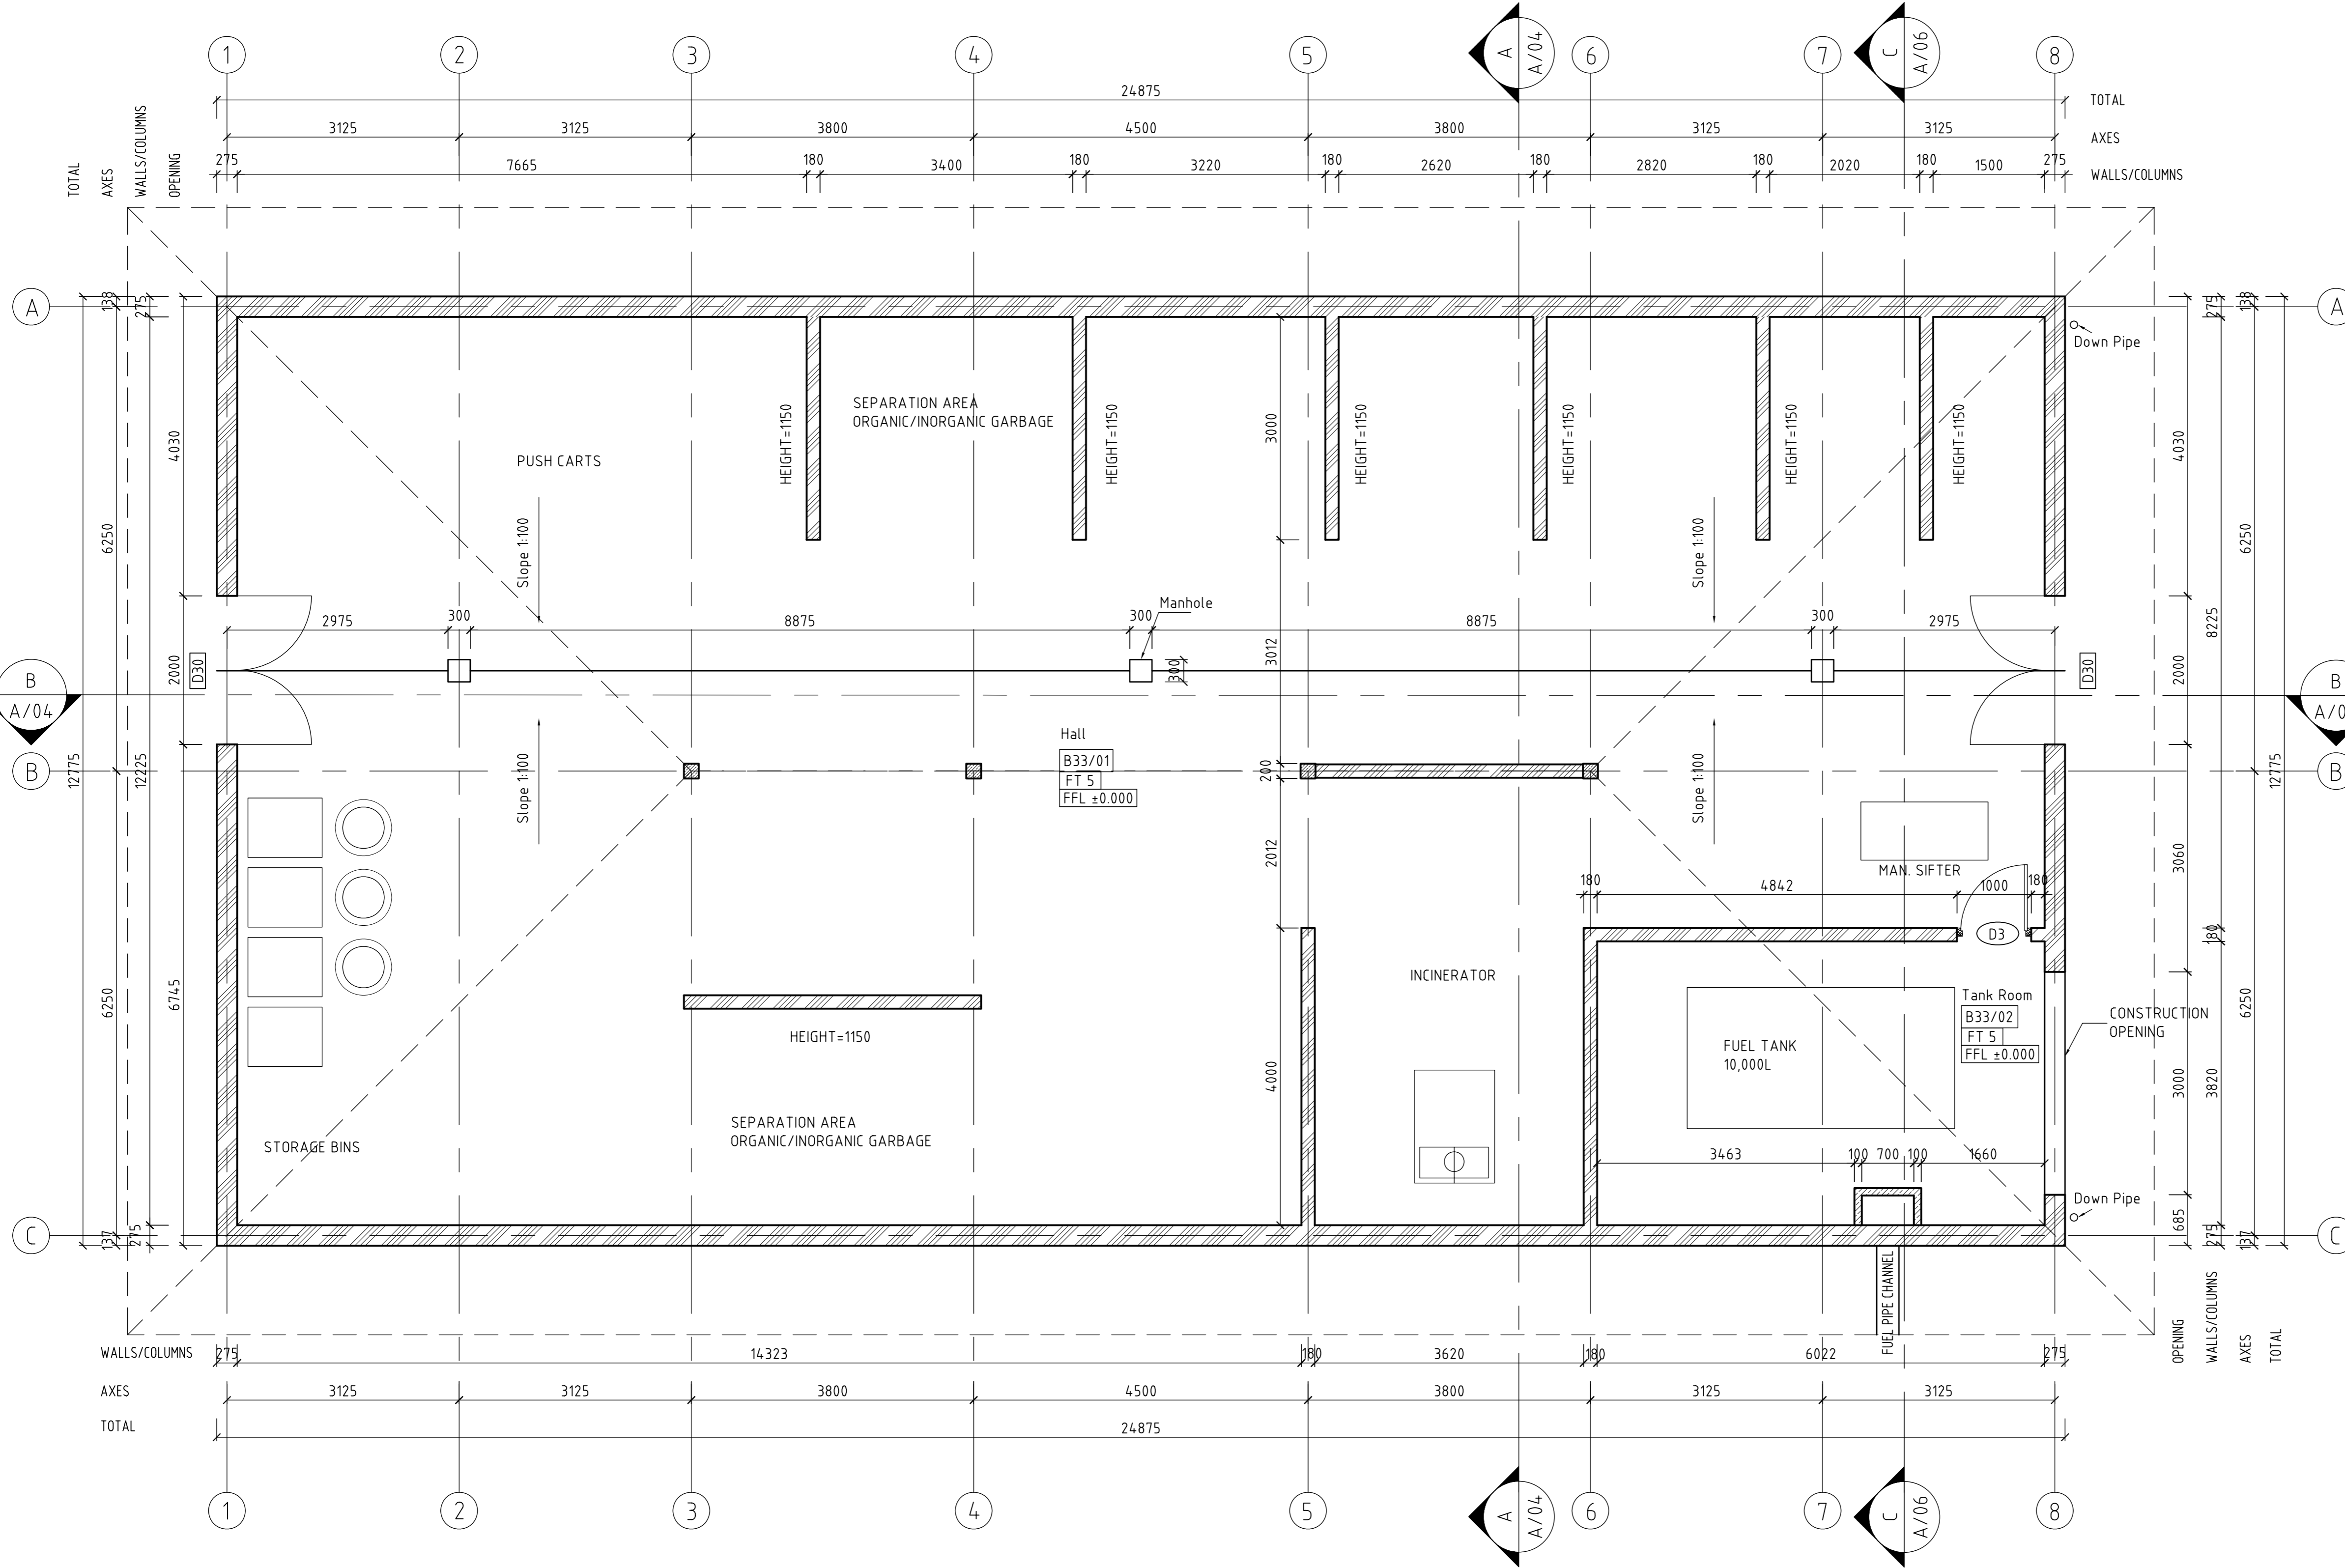

Floor Plan

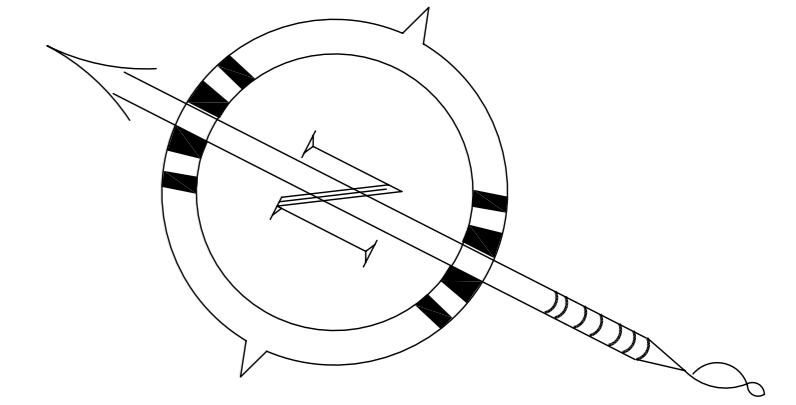

- Legend
- Reinforced Concrete
 - Lean Concrete
 - Solid Brick Masonry
 - Hollow Brick Masonry

AS-BUILT DRAWING



SCALE 1:50

±0.000=9.60m ABOVE SEA LEVEL

DOCUMENT No.	DESCRIPTION
REFERENCES	

No.	CHECK	APPR	DATE	DESCRIPTION
REVISIONS				

**SONJA KILL
MEMORIAL HOSPITAL FOR CHILDREN
KAMPOT CAMBODIA**

Architect
Hans Haff
Pfarrer-Palm-Straße 17
D-53639 Königswinter
Tel. +49 2244 7108 mail: hannahoff@architect@gmx.de

NAME	DATE
Prep. SPN	04.03.08
Check ANK	04.03.08
Chief.Eng.	
P.Mgr.	
SUPERSEDED BY DWG. No.	

**DISPOSAL (B33)
FLOOR PLAN**

PROJECT No. 602	ORIG. SIZE A1	ORIG. SCALE 1:50	DRAWING No. D-B33-AT-01	REV.
--------------------	------------------	---------------------	----------------------------	------