


**Legend**

- Reinforced Concrete
- Lean Concrete
- Solid Brick Masonry
- Hollow Brick Masonry

- Room Number
- Floor Type 5 (Cement Floor)
- Finished Floor Level
- Wooden Window 1 (Locally manufactured)
- Wooden Door Window 1 (Locally manufactured)
- Wooden Ventilation 1 (Locally manufactured)
- Hörmann Doors 7 (Imported)

**AS-BUILT DRAWING**

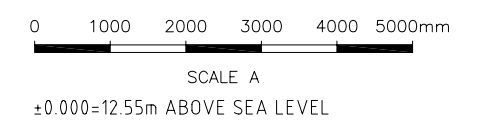

DOCUMENT No.	DESCRIPTION
REFERENCES	

No.	CHECK	APPR	DATE	DESCRIPTION
REVISIONS				

SONJA KILL  
MEMORIAL HOSPITAL FOR CHILDREN  
KAMPOT CAMBODIA


www.il-consult.com

JOHN SANDAY ASSOCIATES

NAME	DATE
Prep. RSN	29.10.07
Check ANK	31.10.07
Chief Eng.	
P.Mgr.	
SUPERSEDED BY DWG. No.	

PROJECT No.	ORIG. SIZE	ORIG. SCALE	DRAWING No.	REV.
602	A1	1:50	D-B36-AT-01	

**FRUITS & BERRIES (B36)  
FLOOR PLAN**

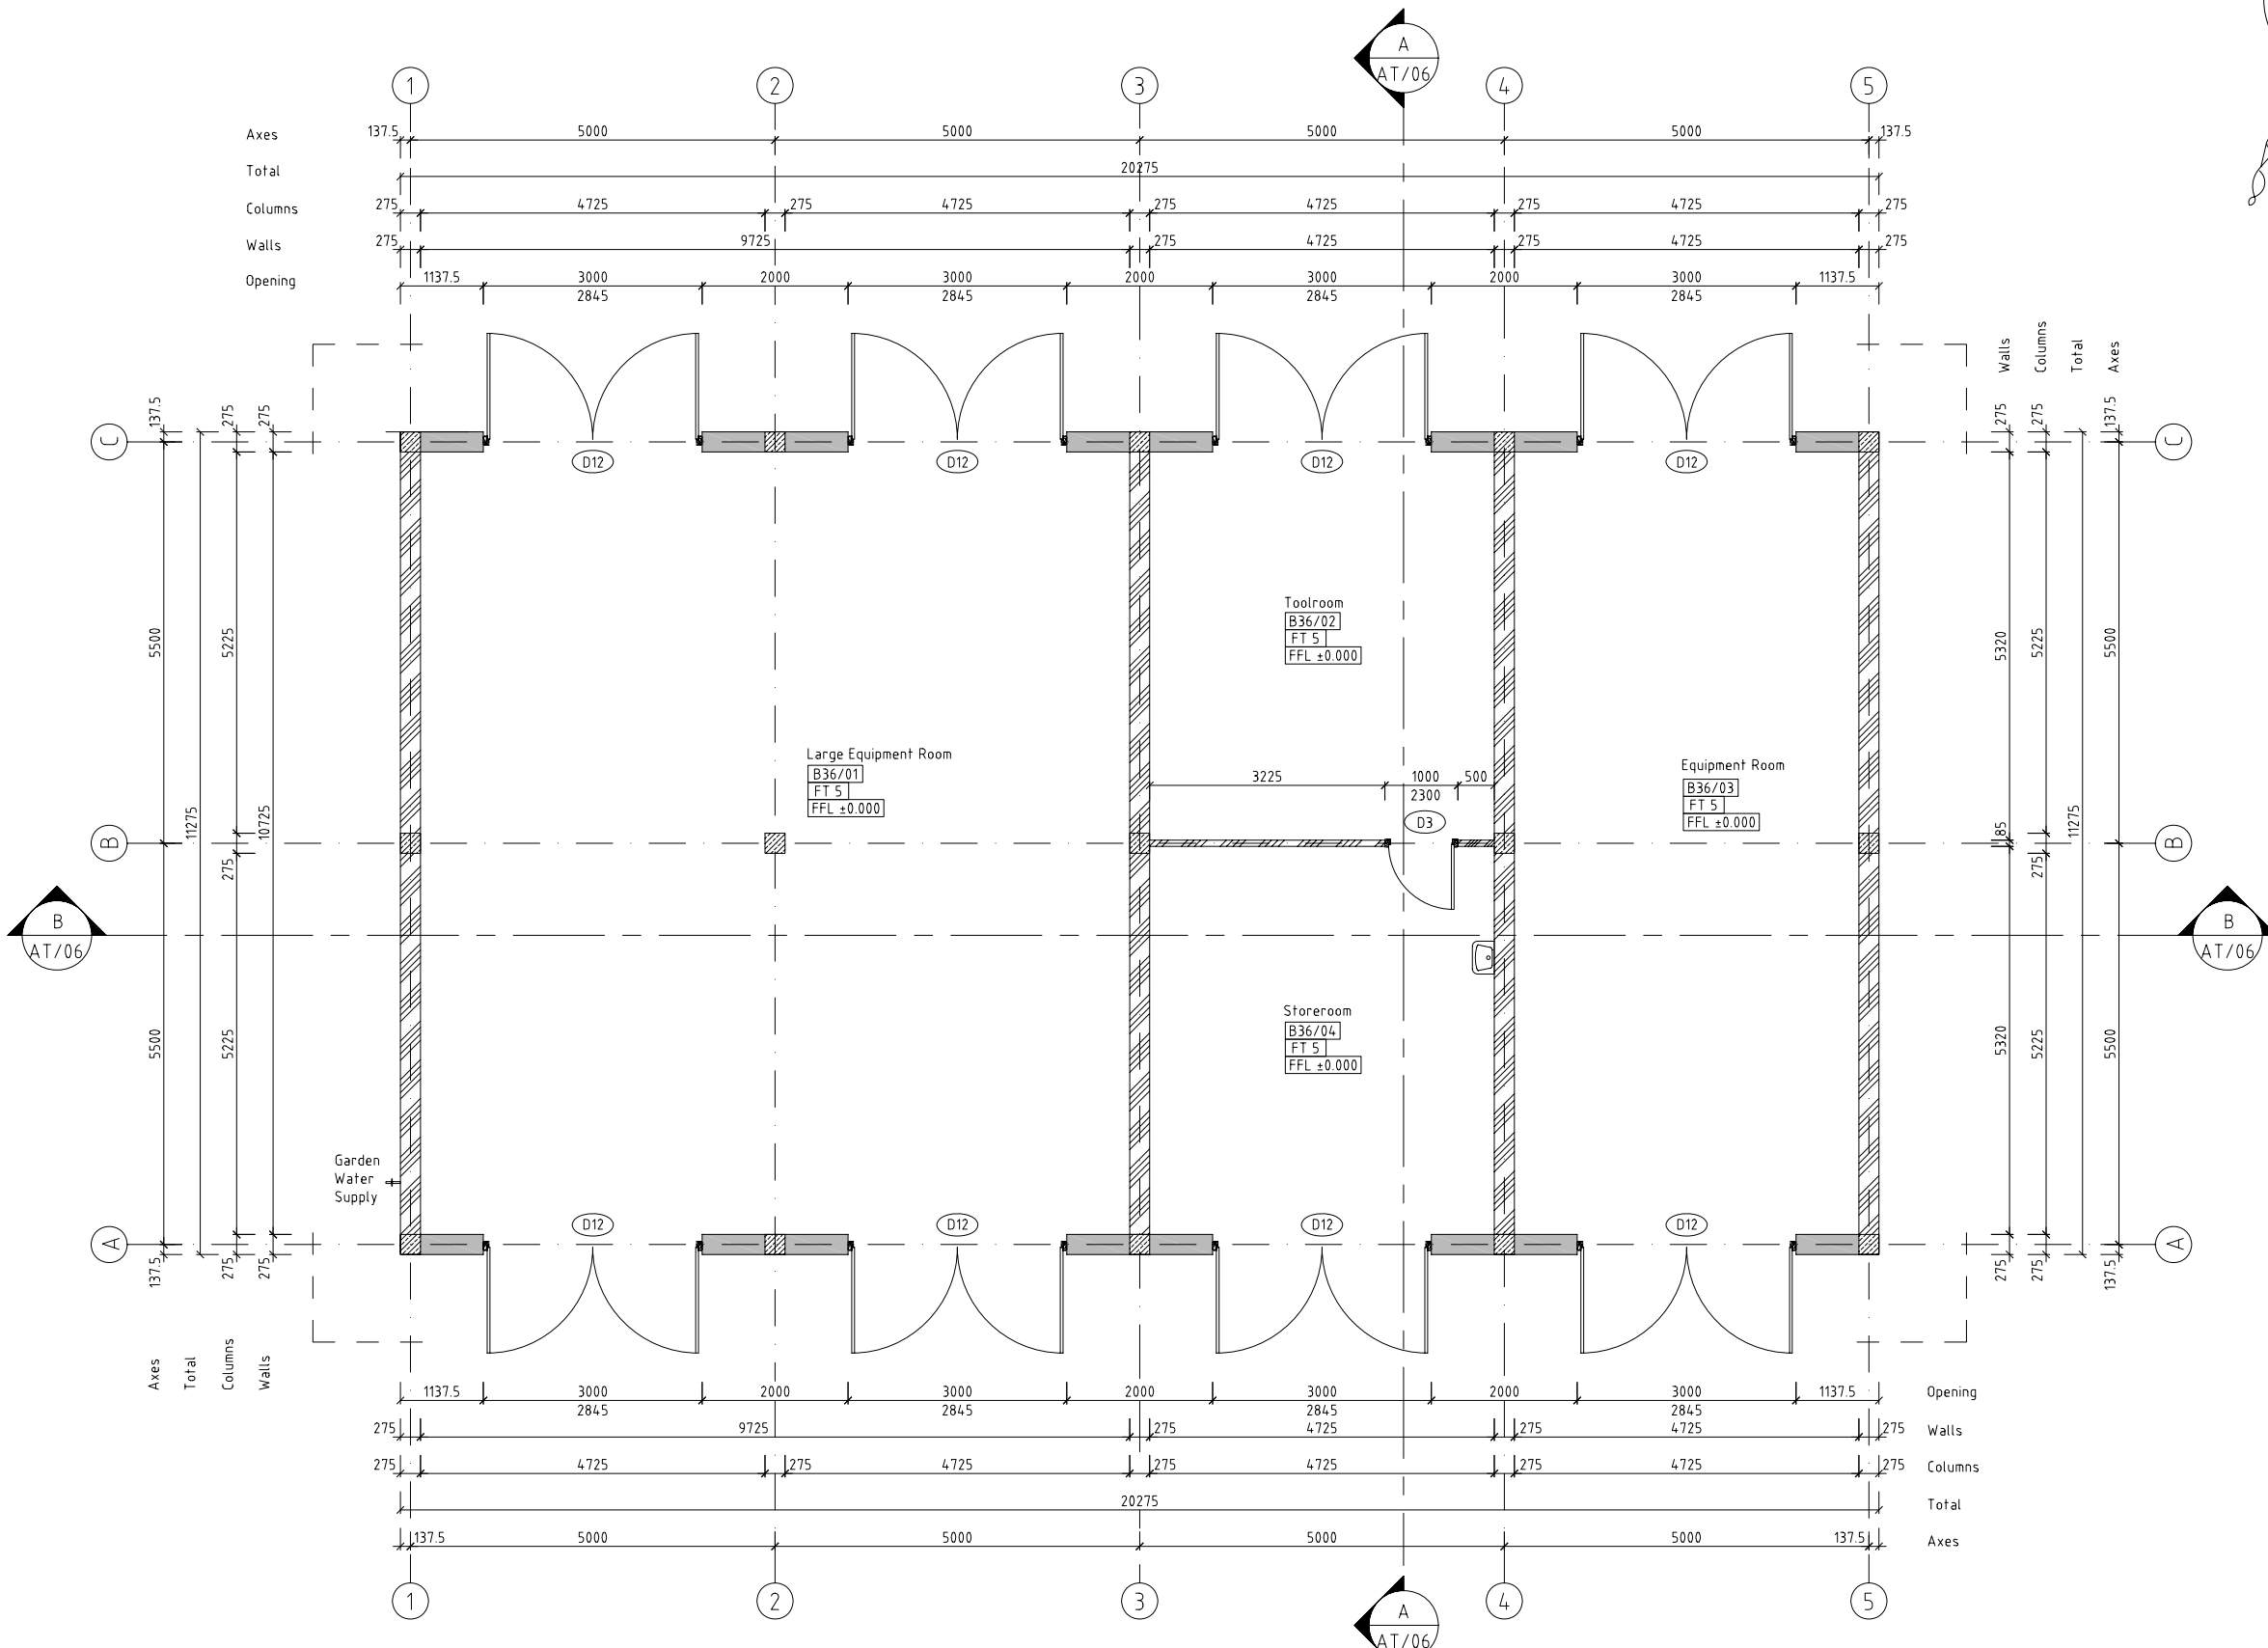

FLOOR PLAN SCALE A