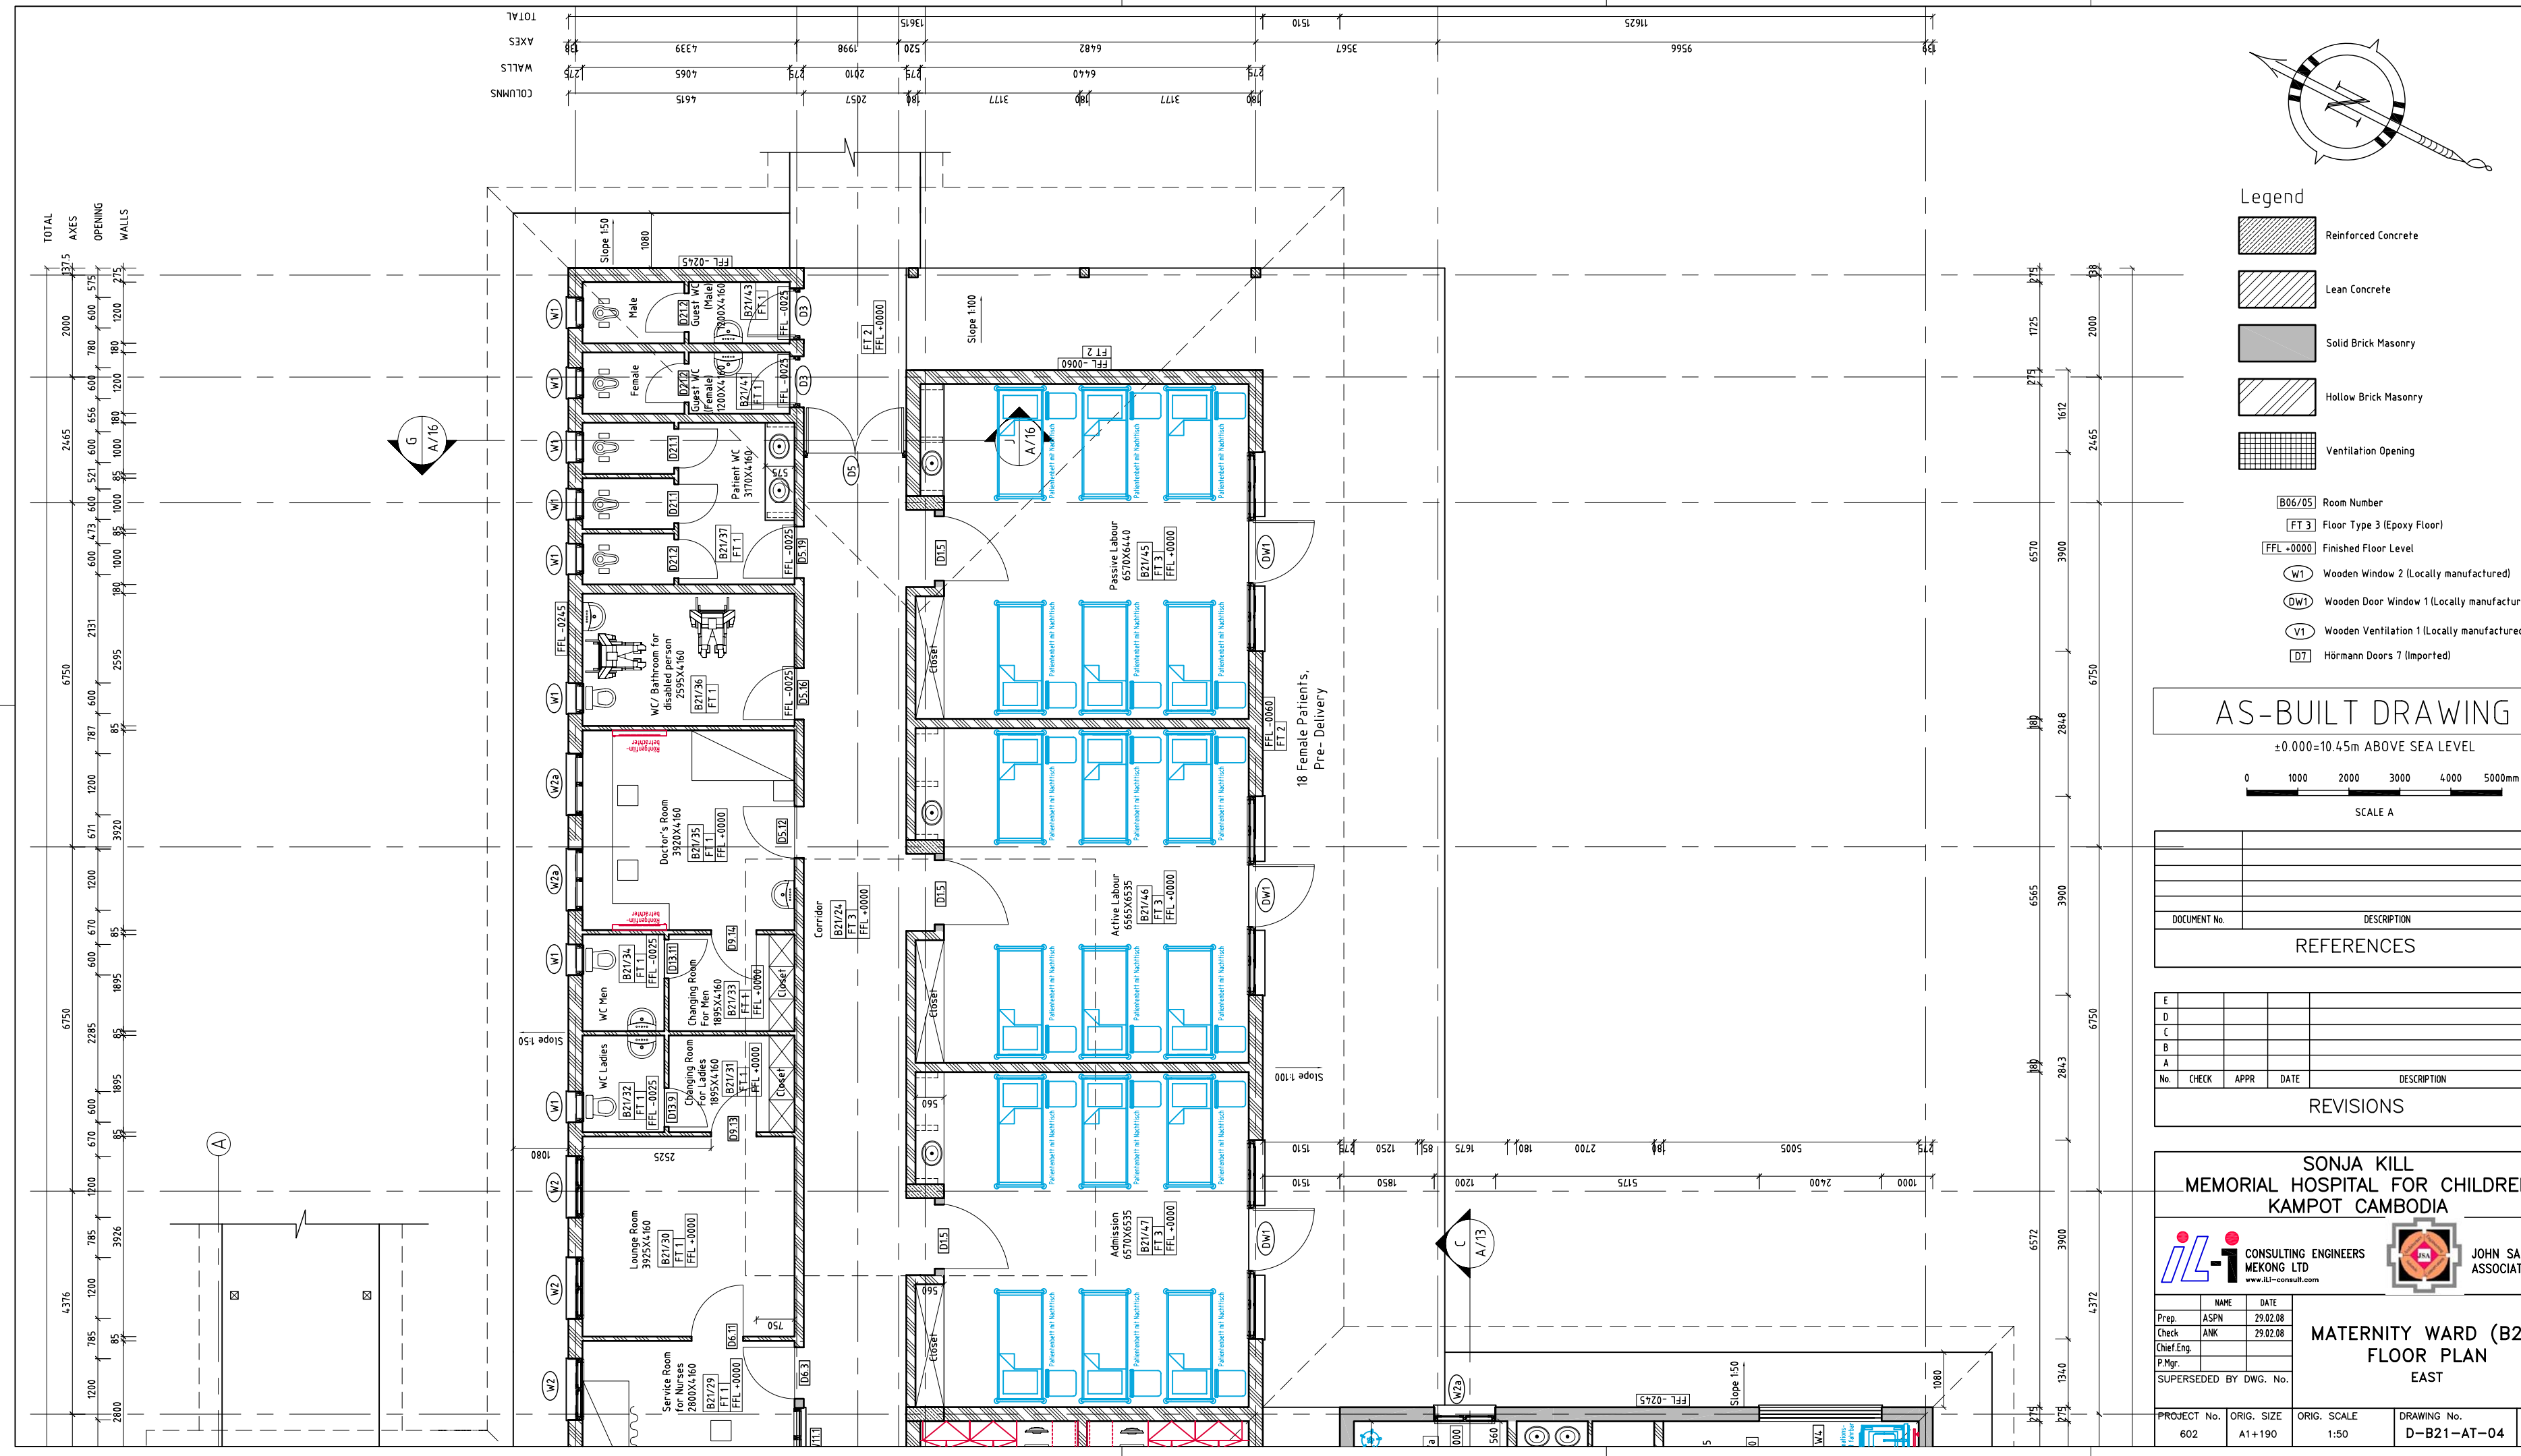

AS-BUILT DRAWING

±0.000=10.45m ABOVE SEA LEVEL

0 1000 2000 3000 4000 5000mm

SCALE A

DOCUMENT No.	DESCRIPTION

REFERENCES

No.	CHECK	APPR	DATE	DESCRIPTION
E				
D				
C				
B				
A				

REVISIONS

SONJA KILL
MEMORIAL HOSPITAL FOR CHILDREN
KAMPOT CAMBODIA

IL-1 CONSULTING ENGINEERS MEKONG LTD
www.IL1-conault.com

JSA JOHN SANDAY ASSOCIATES

	NAME	DATE
Prep.	ASPN	29.02.08
Check	ANK	29.02.08
Chief.Eng.		
P.Mgr.		

SUPERSEDED BY DWG. No.

MATERNITY WARD (B21) FLOOR PLAN

EAST

PROJECT No.	ORIG. SIZE	ORIG. SCALE	DRAWING No.	REV.
602	A1+190	1:50	D-B21-AT-04	